

BERSCH & ASSOCIATES LTD.

July 15, 2013

City of Saskatoon
Infrastructure Services Department
1101 Avenue P North
Saskatoon, Sk.
S7L 7K6

ATTENTION: Brent Anderson

SUBJECT: Fire Hall #3 - Asbestos Registry Report

Please find attached our laboratory's results for the bulk material samples taken from the Fire Hall #3 located at 1906 York Avenue, Saskatoon, SK. The samples were analyzed in our laboratory for the identification of asbestos.

The results for the samples submitted were obtained by examination in accordance with the current USEPA 600/R-93/116 Method for the analysis of asbestos in building materials using polarized light microscopy and dispersion staining techniques. The detection limit of this method is listed as less than 1% by volume.

This test report relates only to the materials sent for examination and any use or extension of the information by the client of these results is the responsibility of the client. If any questions arise on the results of the attached information please contact our office. Thank you for this opportunity of service to your firm.

Included is a floor plan of the facility identifying the bulk sample locations. Photos of suspect materials sampled are also included following the floor plans.

Sincerely,

Dustin Fraess
Bersch & Associates Ltd.
File: B67BLE03

Bersch & Associates Ltd.

Box 3568

Humboldt, Sask. S0K 2A0

PROJECT NO. B67.13**CLIENT: City of Saskatoon****Infrastructure Services - Facilities Branch****Contact: Brent Anderson****Location: Fire Hall #3 - 1906 York Avenue, Saskatoon, SK.**

B67BAE03

BULK SAMPLE ANALYSIS REPORT

NO.	DATE	SAMPLE INFORMATION	ASBESTOS	%	ANALYST
B1	3-May-13	Kitchen 2 - Sheet flooring, white and tan stone pattern with blue and maroon spec	None detected		WB
B2	3-May-13	Room 1 - 1' by 1' ceiling tile above suspended ceiling	None detected		WB
B3	3-May-13	Room 4 - Sheet flooring beneath carpet- red and filler	None detected		WB
B4	3-May-13	Room 12 - Lineal pipe insulation along south wall	None detected		WB
B5	3-May-13	M01 Mezz - Battleship flooring, tan and pink with black swirl	None detected		WB




Infrastructure Services
Department

Facilities Branch
308-875-8890

- GENERAL NOTES:
1. All dimensions are in millimetres.
 2. Drawings are not to be scaled.
 3. All drawings to be read in conjunction with the specifications, unless otherwise noted.
 4. Verify site conditions and location of all utilities prior to construction.
 5. Report all discrepancies to the Consultant.
 6. If in doubt, ask.


ISSUED BY	DATE	REVISIONS BY	DATE
REV. 1	1:100	June 1, 2003	Asbuilt
PROJECT NAME: Asbuilt			
PROJECT TITLE: Main Floor Base Plan			
PROJECT NO.: 823			
SHEET NO.: Firehall #3			
SHEET: 1906 York Ave.			
REV. NO.			

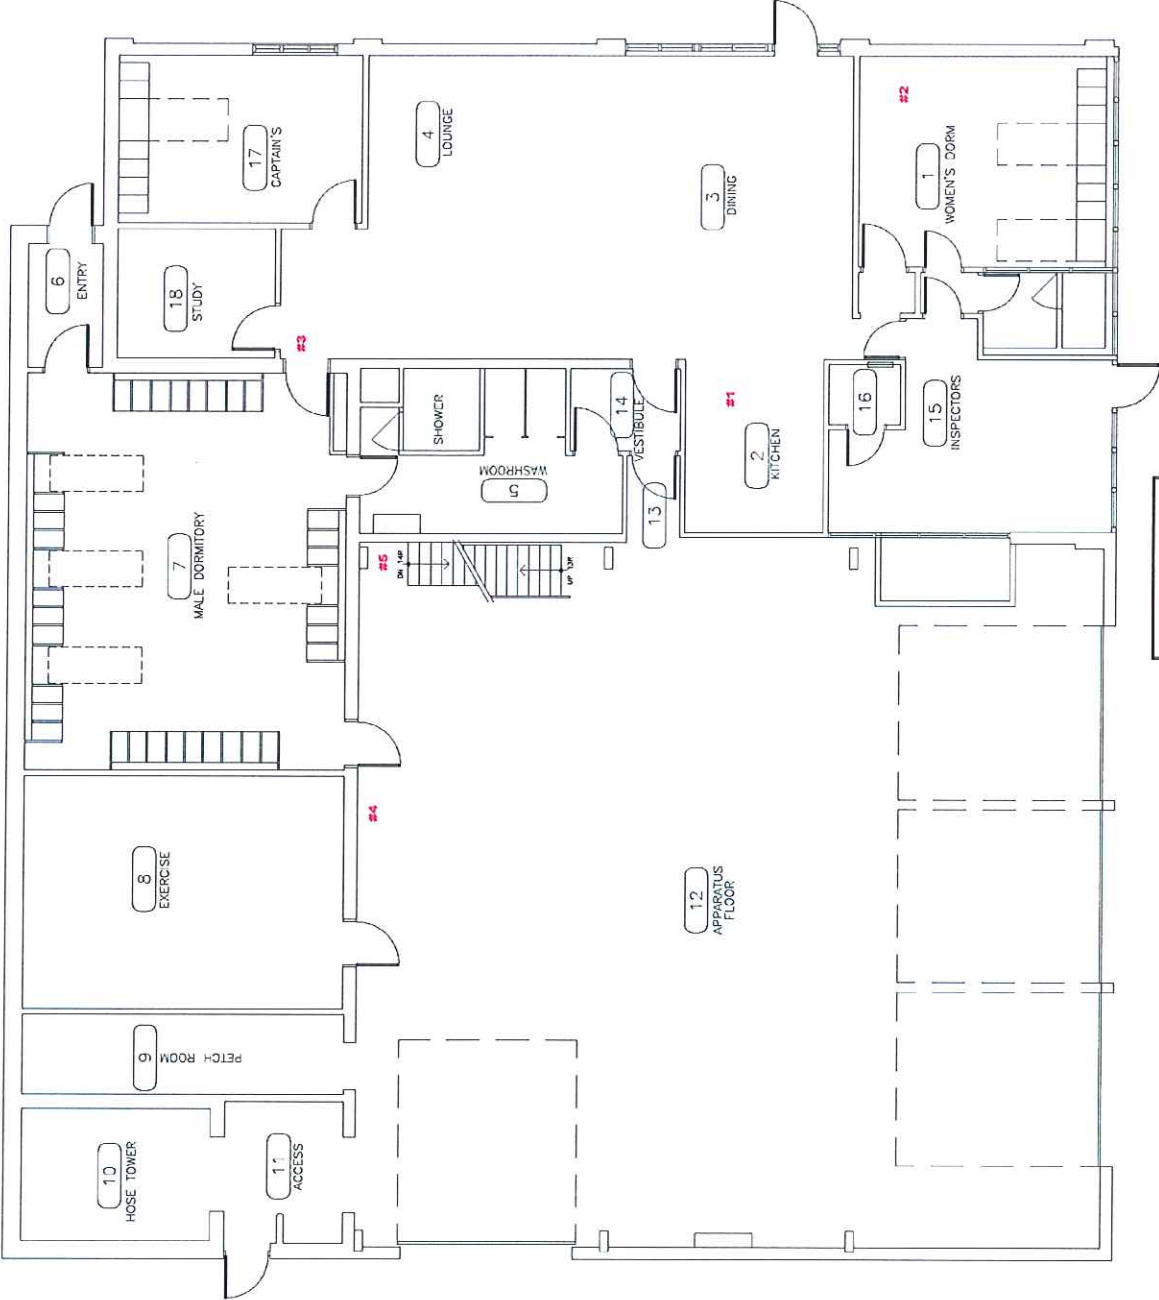

#... - Sample # Location

BULK SAMPLE PHOTOS

#1) Sheet Flooring

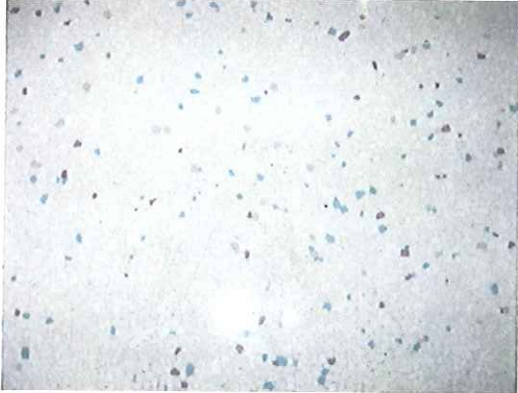

#2) 1' x 1' Ceiling Tile



#3) Sheet Flooring Beneath Carpet



#4) Lineal Pipeline Insulation



#5) Battleship Flooring

